
ENGINEERING REVIEW — SELECT Engineering

- ☐ REVISE AND RESUBMIT
- ☐ REVIEWED, RELEASED FOR DETAIL DESIGN
- ☐ REVIEWED AS NOTED, RELEASED FOR DETAIL DESIGN
- ☑ REVIEWED, RELEASED FOR FABRICATION
- ☐ REVIEWED AS NOTED, RELEASED FOR FABRICATION

APPROVAL OF THESE DRAWINGS DOES NOT RELIEVE THE FABRICATOR OF RESPONSIBILITY FOR DIMENSIONAL ACCURACY, COMPLIANCE WITHT THE PURCHASE ORDER TERMS AND SPECIFICATIONS, AND COMPLIANCE WITH APPLICABLE CODES AND REGULATIONS.

BY jburton **DATE** 5/19/2026

REVISIONS			
REV	**DESCRIPTION**	**BY**	**DATE**
A	APPROVAL FOR CONSTRUCTION ISSUED	KI	4/27/2026
B	ITEM 1 WAS 3070 DOOR	KI	5/8/2026
-	-	-	-

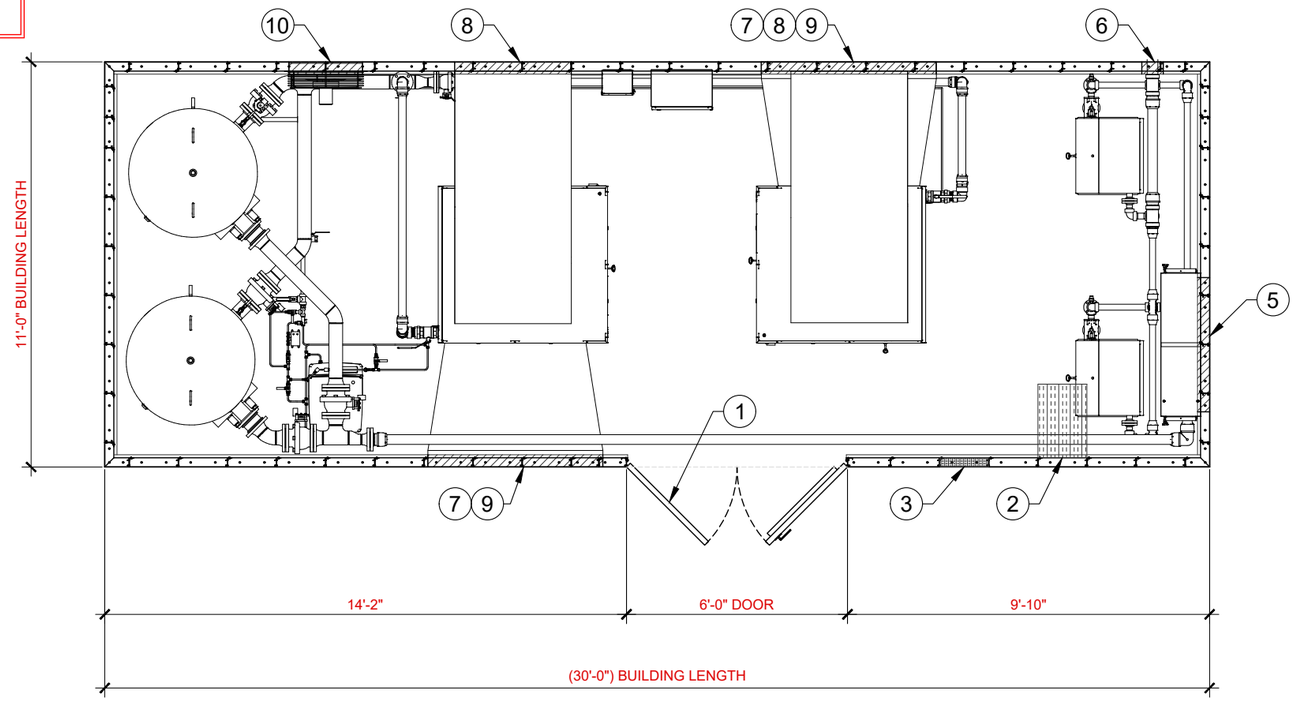

SITE PLAN
3/8"=1'-0"

SHEET NUMBER: 1 OF 3 / SERIAL NUMBER:SERIAL #:1226TES 39181

GENERAL INFORMATION:

- ONE (1) 30'-0" X 11'-0" SF SINGLE SLOPE BUILDING
- 18GA FLAT WALL PANELS 16" X WIDE 3" DEEP
- 18GA FLUSH ROOF PANELS 16" X WIDE 3" DEEP
- COLOR: WHITE
- ROOF PITCH: 1/4 ON 12

BUILDING TO BE ERECTED ON STRUCTURAL SKID

NOTES:

1) ONE - 6080 WALK DOOR 18GA (RHSO, LHSO) W/ PUSH TYPE PANIC, KEYED LEVER HANDLE & CLOSER W/HOLD OPEN ARM.
2) LOT 18GA WHITE METAL CEILING W/6-1/2" FIBERGLASS BATT INSULATION (R-19) WITH 1" THERMAX (R7).
3) LOT 18GA WHITE METAL WALL LINER, W/3-1/2" FIBERGLASS INSULATION (R-13) WITH 1" THERMAX (R7).
4) LOT 18GA WHITE GUTTER, FRONT/EAVE TRIM AND DOWNSPOUTS.
5) ONE - 43 3/4" X 24 1/4" FILTER PACK FRAME WALL OPENING.
6) ONE - WALL PENETRATION FOR 3" PIPING WITH FLASHING.
7) TWO - 57" X 32" WALL OPENINGS FOR AIR INTAKE.
8) TWO - 38" X 38" WALL OPENINGS FOR AIR DISCHARGE.
9) TWO - 15" X 8" WALL OPENINGS FOR COMPRESSOR AIR INTAKE.
10) ONE - 24" X 24" WALL OPENING FOR EXHAUST FAN.

CUSTOMER INFORMATION:

TESCORP JOB#: 43026
TESCORP PO#: 13918

PRODUCED BY:


A1 SHEET METAL, LLC
9410 East 54th ST.
Tulsa, OK., 74145
(918) 835-6200

TITLE: 30'-0" X 11'-0" - SF SINGLE SLOPE					
DWN BY:	KI	SCALE:	SEE PLAN	DWG NO:	AA-3011-2617
CKD:	MJ	DATE:	4/27/2026	JOB NO:	43026
APPRD:	MJ/GS	WEIGHT:		REV:	B


CUSTOMER APPROVAL	
CUST:	TESCORP
BY:	----
DATE:	----

DRAWINGS ARE CONFIDENTIAL AND PROPRIETARY. REPRODUCTION OR MODIFICATION IS PROHIBITED WITHOUT EXPRESS WRITTEN CONSENT FROM A1 SHEET METAL

REVISIONS			
REV	DESCRIPTION	BY	DATE
A	APPROVAL FOR CONSTRUCTION ISSUED	KI	4/27/2026
B	ITEM 1 WAS 3070 DOOR	KI	5/8/2026
-	-	-	-

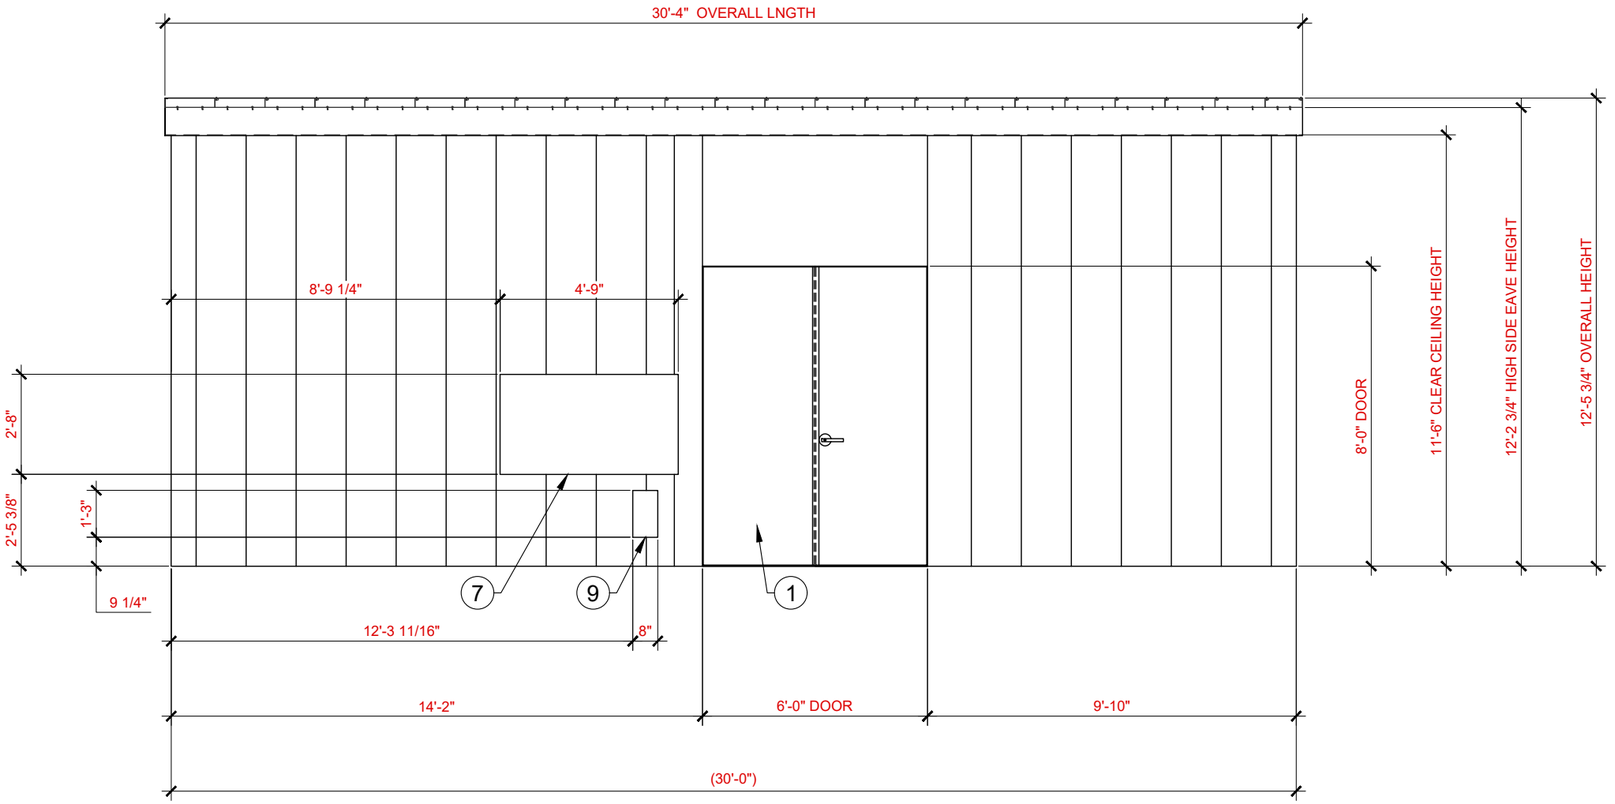

FRONT ELEVATION
1/4"=1'-0"

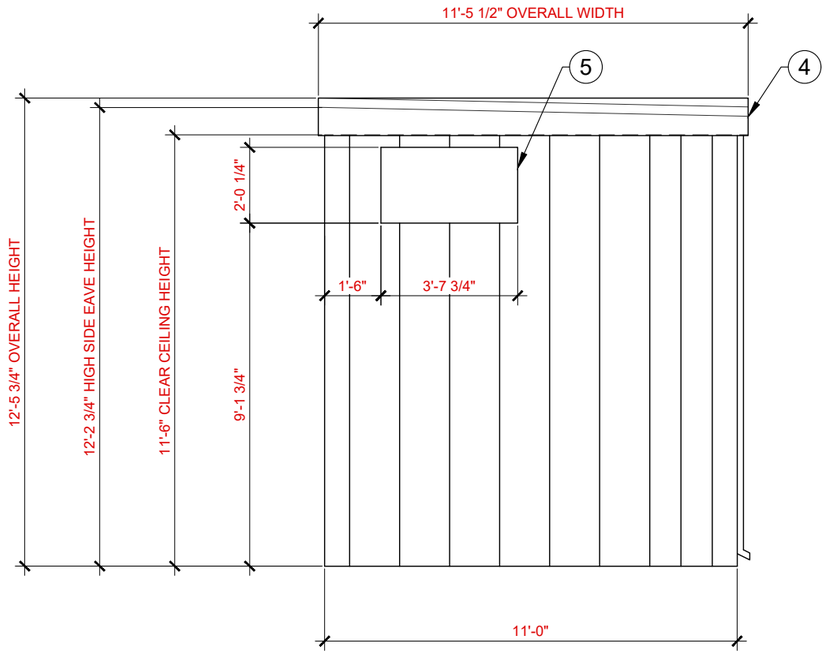

RIGHT ELEVATION
1/4"=1'-0"

GENERAL INFORMATION:

- ONE (1) 30'-0" X 11'-0" SF SINGLE SLOPE BUILDING
- 18GA FLAT WALL PANELS 16" X WIDE 3" DEEP
- 18GA FLUSH ROOF PANELS 16" X WIDE 3" DEEP
- COLOR: WHITE
- ROOF PITCH: 1/4 ON 12

BUILDING TO BE ERECTED ON STRUCTURAL SKID

NOTES:

1) ONE - 6080 WALK DOOR 18GA (RHSO, LHSO) W/ PUSH TYPE PANIC, KEYED LEVER HANDLE & CLOSER W/HOLD OPEN ARM.
2) LOT 18GA WHITE METAL CEILING W/6-1/2" FIBERGLASS BATT INSULATION (R-19) WITH 1" THERMAX (R7).
3) LOT 18GA WHITE METAL WALL LINER, W/3-1/2" FIBERGLASS INSULATION (R-13) WITH 1" THERMAX (R7).
4) LOT 18GA WHITE GUTTER, FRONT/EAVE TRIM AND DOWNSPOUTS.
5) ONE - 43 3/4" X 24 1/4" FILTER PACK FRAME WALL OPENING.
6) ONE - WALL PENETRATION FOR 3" PIPING WITH FLASHING.
7) TWO - 57" X 32" WALL OPENINGS FOR AIR INTAKE.
8) TWO - 38" X 38" WALL OPENINGS FOR AIR DISCHARGE.
9) TWO - 15" X 8" WALL OPENINGS FOR COMPRESSOR AIR INTAKE.
10) ONE - 24" X 24" WALL OPENING FOR EXHAUST FAN.

CUSTOMER INFORMATION:

TESCORP JOB#: 43026
TESCORP PO#: 13918

PRODUCED BY:

A1 SHEET METAL, LLC
9410 East 54th ST.
Tulsa, OK., 74145
(918) 835-6200


TITLE: 30'-0" X 11'-0" - SF SINGLE SLOPE					
DWN BY:	KI	SCALE:	SEE PLAN	DWG NO:	AA-3011-2617
CKD:	MJ	DATE:	4/27/2026	JOB NO:	43026
APPRD:	MJ/GS	WEIGHT:		REV:	B

CUSTOMER APPROVAL	
CUST:	TESCORP
BY:	----
DATE:	----


DRAWINGS ARE CONFIDENTIAL AND PROPRIETARY. REPRODUCTION OR MODIFICATION IS PROHIBITED WITHOUT EXPRESS WRITTEN CONSENT FROM A1 SHEET METAL

SHEET NUMBER: 2 OF 3 / SERIAL NUMBER:SERIAL #:1226TES 39181

REVISIONS			
REV	DESCRIPTION	BY	DATE
A	APPROVAL FOR CONSTRUCTION ISSUED	KI	4/27/2026
B	ITEM 1 WAS 3070 DOOR	KI	5/8/2026
-	-	-	-

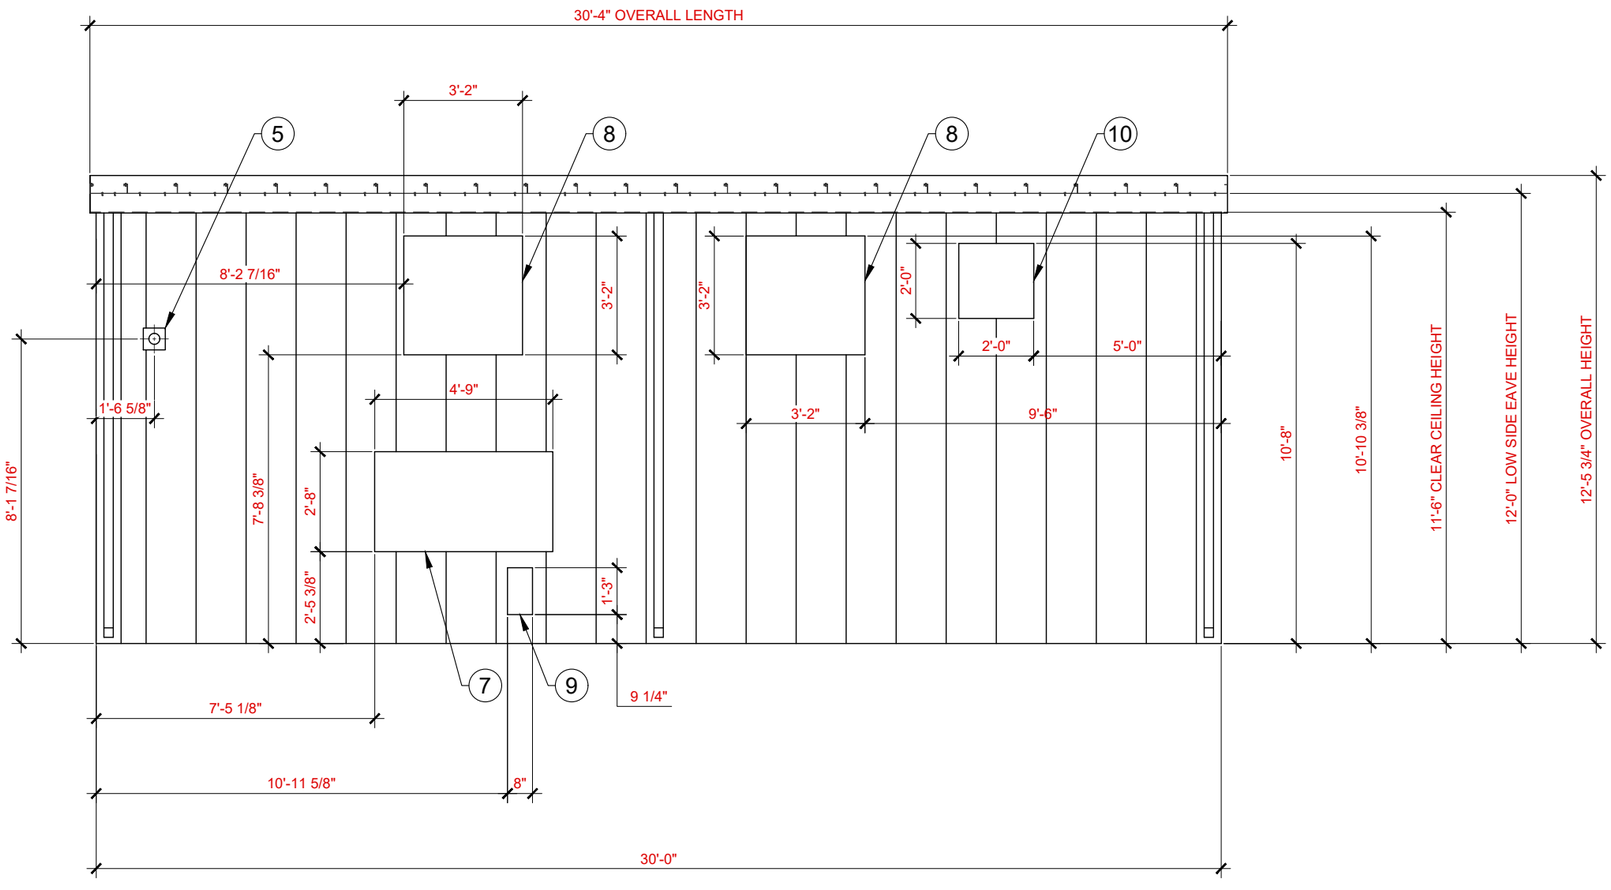

BACK ELEVATION
1/4"=1'-0"

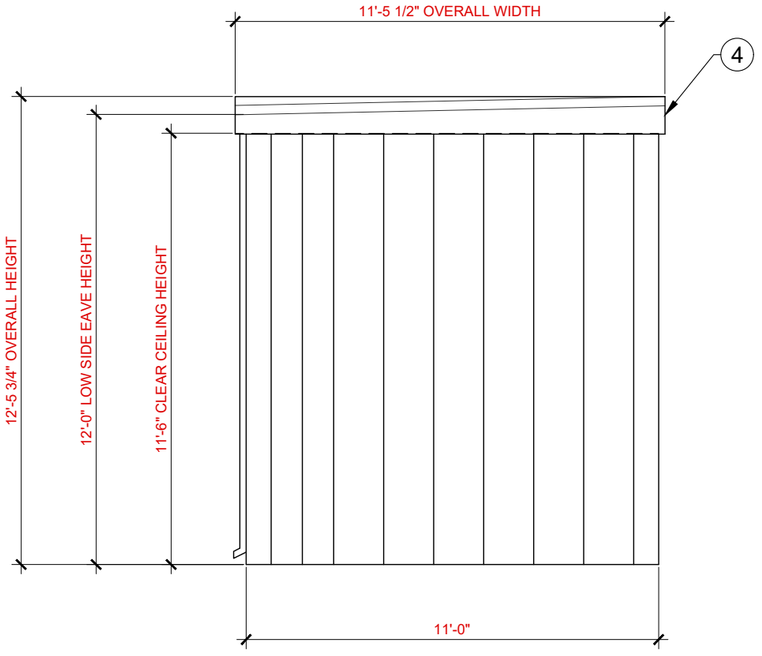

LEFT ELEVATION
1/4":1'-0"

GENERAL INFORMATION:

- ONE (1) 30'-0" X 11'-0" SF SINGLE SLOPE BUILDING
- 18GA FLAT WALL PANELS 16" X WIDE 3" DEEP
- 18GA FLUSH ROOF PANELS 16" X WIDE 3" DEEP
- COLOR: WHITE
- ROOF PITCH: 1/4 ON 12

BUILDING TO BE ERECTED ON STRUCTURAL SKID

NOTES:

1) ONE - 6080 WALK DOOR 18GA (RHSO, LHSO) W/ PUSH TYPE PANIC, KEYED LEVER HANDLE & CLOSER W/HOLD OPEN ARM.
2) LOT 18GA WHITE METAL CEILING W/6-1/2" FIBERGLASS BATT INSULATION (R-19) WITH 1" THERMAX (R7).
3) LOT 18GA WHITE METAL WALL LINER, W/3-1/2" FIBERGLASS INSULATION (R-13) WITH 1" THERMAX (R7).
4) LOT 18GA WHITE GUTTER, FRONT/EAVE TRIM AND DOWNSPOUTS.
5) ONE - 43 3/4" X 24 1/4" FILTER PACK FRAME WALL OPENING.
6) ONE - WALL PENETRATION FOR 3" PIPING WITH FLASHING.
7) TWO - 57" X 32" WALL OPENINGS FOR AIR INTAKE.
8) TWO - 38" X 38" WALL OPENINGS FOR AIR DISCHARGE.
9) TWO - 15" X 8" WALL OPENINGS FOR COMPRESSOR AIR INTAKE.
10) ONE - 24" X 24" WALL OPENING FOR EXHAUST FAN.

CUSTOMER INFORMATION:

TESCORP JOB#: 43026
TESCORP PO#: 13918

PRODUCED BY:

A1 SHEET METAL, LLC
9410 East 54th ST.
Tulsa, OK., 74145
(918) 835-6200

TITLE: 30'-0" X 11'-0" - SF SINGLE SLOPE					
DWN BY:	KI	SCALE:	SEE PLAN	DWG NO:	AA-3011-2617
CKD:	MJ	DATE:	4/27/2026	JOB NO:	43026
APPRD:	MJ/GS	WEIGHT:		REV:	B

CUSTOMER APPROVAL	
CUST:	TESCORP
BY:	----
DATE:	----

DRAWINGS ARE CONFIDENTIAL AND PROPRIETARY. REPRODUCTION OR MODIFICATION IS PROHIBITED WITHOUT EXPRESS WRITTEN CONSENT FROM A1 SHEET METAL

SHEET NUMBER: 3 OF 3 / SERIAL NUMBER:SERIAL #:1226TES 39181